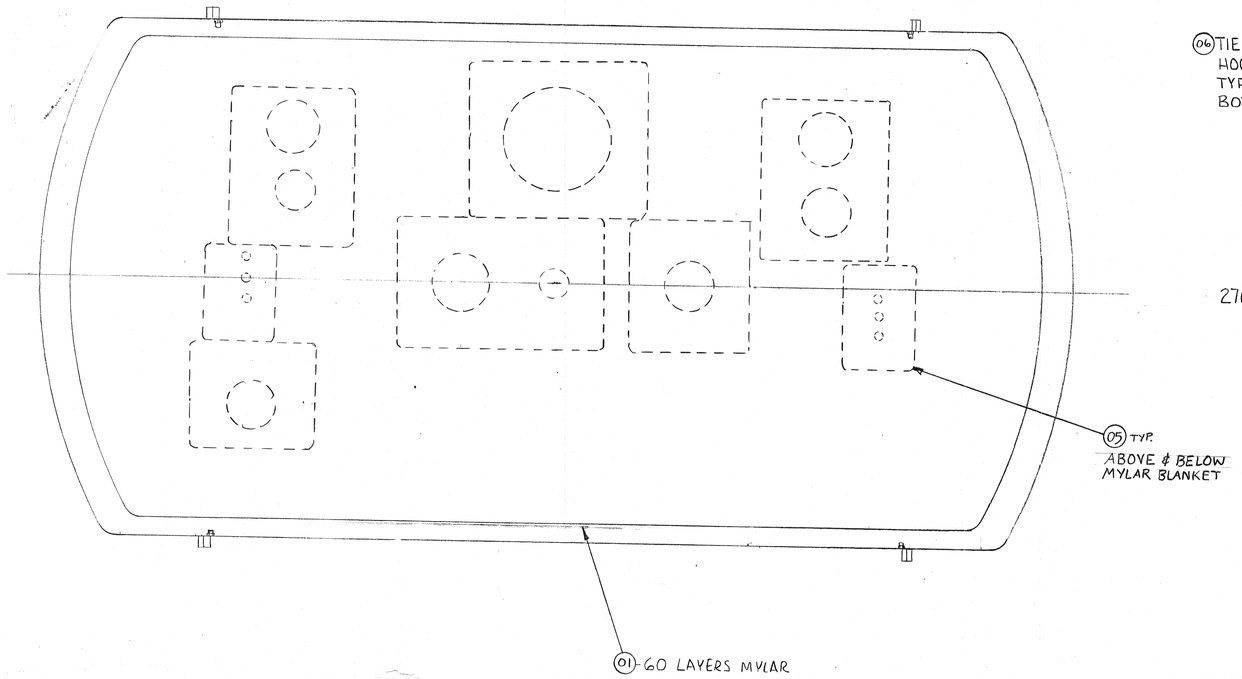

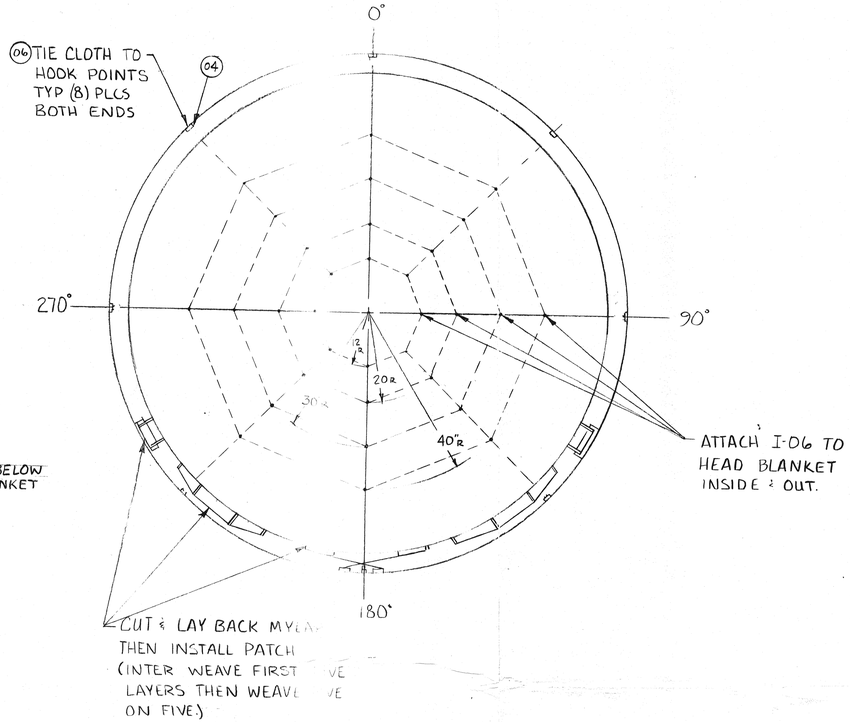

APPROVAL

△NOTE:
DO NOT INSULATE
WINDOW AREAS.

OCT 18 1988

(05) FIBER-FRAX INSULATION
MAT IN ALL AREAS IN
CONTACT W/ WELD JOINTS

△ (03) MYLAR TAPE - USE MINIMUM AMOUNT POSSIBLE

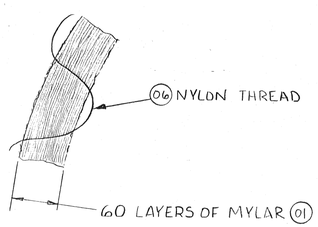

DETAIL OF HEAD BLANKET

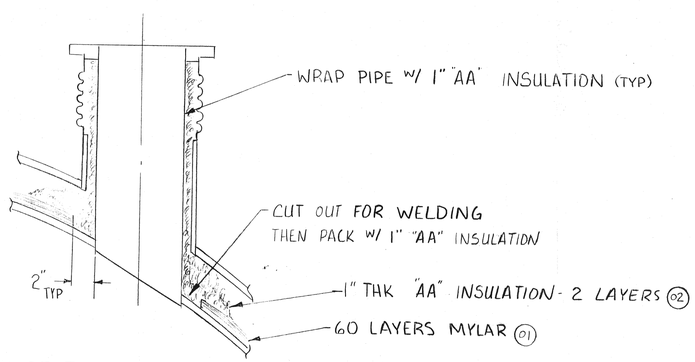

DETAIL OF TYP NOZZ

APPROVED
APPROVED AS NOTED — RESUBMIT
APPROVED AS NOTED — RESUBMITTAL NOT REQUIRED
DISAPPROVED
REVIEWED FOR GENERAL DESIGN CONCEPTS ONLY. VARIANCE FROM PROCUREMENT SPECIFICATIONS, DRAWINGS OR OTHER PROCUREMENT DOCUMENTS MUST BE SPECIFICALLY APPROVED BY THE PROCURING ORGANIZATION. THIS REVIEW DOES NOT RELIEVE THE VENDOR FROM THE RESPONSIBILITY OF FURNISHING PRODUCT IN ACCORDANCE WITH CONTRACT DOCUMENTS.
DATE: 10-25-88
REVIEWED BY: R L Schmitz
FERMI NATIONAL ACCELERATOR LABORATORY

MK	REVISION	BY	DATE
2	ADDED NOZZLE LOCATIONS PER LDH	SAM	10-17-88
1	ADDED NOTES PER LDH	SAM	2-3-88

STANDARD TOLERANCE TO BE: $\pm \frac{1}{8}$ UNLESS OTHERWISE NOTED.

THIS DRAWING AND DESIGN TO BE THE PROPERTY OF THE RICHMOND-LOX EQUIPMENT CO. AND IS SUBMITTED ON THE CONDITION THAT IT IS NOT TO BE COPIED, IN WHOLE OR IN PART, OR USED FOR ANY PURPOSE DETRIMENTAL TO THE RICHMOND-LOX EQUIPMENT COMPANY.

RICHMOND-LOX EQUIPMENT COMPANY
DELPHI DIVISION
BOX 198, DELPHI, INDIANA 46923

TITLE: INSULATION INSTALLATION TEST DW

		DATE
DRAWN	SAM	13-88
CHECKED	LDH	12-88
APPROVED	LDH	14-88
SCALE		
DWG. NO.	D87-0783	REV. 2